

FOR INFORMATION ONLY  
 SKETCH DESIGN  
 COUNCIL SUBMISSION  
 FOR TENDER  
 FOR CONSTRUCTION

DOVEY MARTIN

PROJECT  
 ALT'S & ADDS TO EX.  
 RES. DOVEY MARTIN  
 ERF 2858, FRANSCH'K

DRAWING TITLE  
 AS BUILT DRAWINGS  
 FLOOR PLAN  
 LAYOUTS


ARCHITECT

OWNER


SCALE 1:100 DATE SEPT 2016

DWG NO. 029/DOV/2016-04 REV

THE DESIGN SHOWN ON THIS DRAWING IS THE COPYRIGHT OF THE ARCHITECT. FIGURED DIMENSIONS TO BE TAKEN IN PREFERENCE TO SCALED MEASUREMENTS. THE CONTRACTOR MUST VERIFY ALL DIMENSIONS AND LEVELS BEFORE COMMENCING ANY WORK. SUB-CONTRACTORS MUST VERIFY ALL DIMENSIONS OF THE JOB AND SUBMIT SHOP DRAWINGS TO THE ARCHITECT BEFORE COMMENCING ANY WORK. FOR REINFORCING CONCRETE AND STRUCTURAL STEEL WORK SEE ENGINEER'S DRAWINGS.

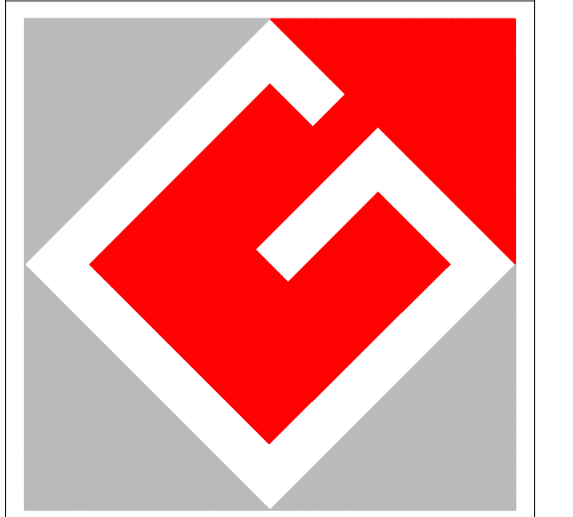

Graham Goosen  
**ARCHITECTS**  
 21 LA COTTE STREET FRANSCHHOEK 7690  
 TEL 021 8762930 info@ggarchitects.co.za

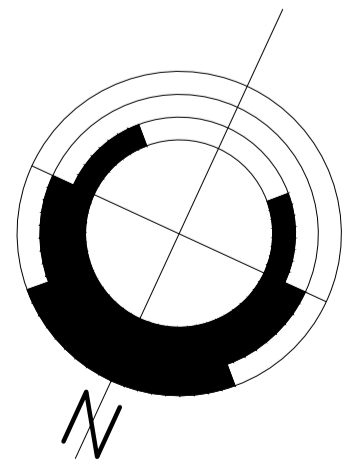

AS BUILT DRAWINGS, ERF 2858, LA' AVENUE, FRANSCHHOEK